FIRE ALARM SIGNALING LINE CIRCUIT ADDRESS LISTS – DETAIL 1

LOOP 1 – 1ST FLOOR EAST

ADDRESS	SMOKE DETECTOR WITH STANDARD BASE	SMOKE DETECTOR WITH REMOTE ALARM BASE	SMOKE DETECTOR WITH RELAY BASE	SMOKE DETECTOR MOUNTED ON HORIZONTAL SIDEWALL	TRI-R	TRI-D WATERFLOW SWITCH	TRI-D VALVE SUPERVISION	MANUAL FIRE CALL BOX	HEAT DETECTOR WITH STND BASE	COMMENTS
L1 -01	●									
L1 -02					●					FSD EAST SIDE
L1 -03					●					FSD WEST SIDE
L1 -04	●									
L1 -05	●									
L1 -06	●									
L1 -07	●									
L1 -08	●									
L1 -09			●							SMOKEGUARD
L1 -10								●		
L1 -11					●					DOOR HOLDERS
L1 -12	●									
L1 -13						●				
L1 -14							●			
L1 -15							●			
L1 -16				●						
L1 -17	●									
L1 -18	●									
L1 -19	●									
L1 -20	●									
L1 -21	●									
L1 -22				●						
L1 -23	●									
L1 -24				●						
L1 -25	●									
L1 -26	●									
L1 -27				●						
L1 -28				●						
L1 -29	●									
L1 -30	●									
L1 -31				●						
L1 -32	●									
L1 -33	●									
L1 -34				●						
L1 -35	●									
L1 -36	●									
L1 -37	●									
L1 -38	●									
L1 -39				●						
L1 -40	●									
L1 -41	●									
L1 -42				●						
L1 -43					●					DOOR HOLDERS
L1 -44	●									
L1 -45	●									
L1 -46										
L1 -47										
L1 -48										
L1 -49										
L1 -50										
L1 -51										
L1 -52										
L1 -53										
L1 -54										
L1 -55										
L1 -56										
L1 -57										
L1 -58										
L1 -59										
L1 -60										
TOTAL	27	0	1	9	4	1	2	1	0	

LOOP 2 – 1ST FLOOR WEST

ADDRESS	SMOKE DETECTOR WITH STANDARD BASE	SMOKE DETECTOR WITH REMOTE ALARM BASE	SMOKE DETECTOR WITH RELAY BASE	SMOKE DETECTOR MOUNTED ON HORIZONTAL SIDEWALL	TRI-R	TRI-D WATERFLOW SWITCH	TRI-D VALVE SUPERVISION	MANUAL FIRE CALL BOX	HEAT DETECTOR WITH STND BASE	COMMENTS
L2 -01				●						
L2 -02	●									
L2 -03	●									
L2 -04				●						
L2 -05	●									
L2 -06				●						
L2 -07	●									
L2 -08				●						
L2 -09	●									
L2 -10	●									
L2 -11				●						
L2 -12	●									
L2 -13				●						
L2 -14	●									
L2 -15	●									
L2 -16	●									
L2 -17										NOT USED
L2 -18					●					FAN SHUTDOWN
L2 -19					●					FAN RUN STATUS
L2 -20			●							SMOKEGUARD
L2 -21	●									
L2 -22					●					DOOR HOLDERS
L2 -23	●									
L2 -24								●		
L2 -25							●			
L2 -26							●			
L2 -27						●				
L2 -28	●									
L2 -29					●					DOOR HOLDERS
L2 -30	●									
L2 -31	●									
L2 -32								●		
L2 -33	●									
L2 -34	●									
L2 -35	●									
L2 -36	●									
L2 -37								●		
L2 -38	●									
L2 -39										
L2 -40										
L2 -41										
L2 -42										
L2 -43										
L2 -44										
L2 -45										
L2 -46										
L2 -47										
L2 -48										
L2 -49										
L2 -50										
L2 -51										
L2 -52										
L2 -53										
L2 -54										
L2 -55										
L2 -56										
L2 -57										
L2 -58										
L2 -59										
L2 -60										
TOTAL	20	0	1	6	4	1	2	3	0	

LOOP 3 – 2ND FLOOR EAST

ADDRESS	SMOKE DETECTOR WITH STANDARD BASE	SMOKE DETECTOR WITH REMOTE ALARM BASE	SMOKE DETECTOR WITH RELAY BASE	SMOKE DETECTOR MOUNTED ON HORIZONTAL SIDEWALL	TRI-R	TRI-D WATERFLOW SWITCH	TRI-D VALVE SUPERVISION	MANUAL FIRE CALL BOX	HEAT DETECTOR WITH STND BASE	COMMENTS
L3 -01	●									
L3 -02					●					FSD EAST SIDE
L3 -03					●					FSD WEST SIDE
L3 -04	●									
L3 -05	●									
L3 -06			●							SMOKEGUARD
L3 -07					●					DOOR HOLDERS
L3 -08	●									
L3 -09						●				
L3 -10							●			
L3 -11								●		
L3 -12	●									
L3 -13				●						
L3 -14		●								ABOVE CLOUD CEILING
L3 -15				●						
L3 -16		●								ABOVE CLOUD CEILING
L3 -17	●									
L3 -18	●									
L3 -19	●									
L3 -20				●						
L3 -21		●								ABOVE CLOUD CEILING
L3 -22				●						
L3 -23		●								ABOVE CLOUD CEILING
L3 -24				●						
L3 -25		●								ABOVE CLOUD CEILING
L3 -26	●									
L3 -27	●									
L3 -28				●						
L3 -29					●					DOOR HOLDERS
L3 -30		●								ABOVE CLOUD CEILING
L3 -31				●						
L3 -32	●									
L3 -33		●								ABOVE CLOUD CEILING
L3 -34				●						
L3 -35		●								ABOVE CLOUD CEILING
L3 -36	●									
L3 -37				●						
L3 -38	●									
L3 -39	●									
L3 -40								●		HAZ MAT SPILL ALARM
L3 -41								●		HAZ MAT SPILL ALARM
L3 -42										
L3 -43										
L3 -44										
L3 -45										
L3 -46										
L3 -47										
L3 -48										
L3 -49										
L3 -50										
L3 -51										
L3 -52										
L3 -53										
L3 -54										
L3 -55										
L3 -56										
L3 -57										
L3 -58										
L3 -59										
L3 -60										
TOTAL	14	8	1	9	4	1	1	3	0	

LOOP 4 – 2ND FLOOR WEST

ADDRESS	SMOKE DETECTOR WITH STANDARD BASE	SMOKE DETECTOR WITH REMOTE ALARM BASE	SMOKE DETECTOR WITH RELAY BASE	SMOKE DETECTOR MOUNTED ON HORIZONTAL SIDEWALL	TRI-R	TRI-D WATERFLOW SWITCH	TRI-D VALVE SUPERVISION	MANUAL FIRE CALL BOX	HEAT DETECTOR WITH STND BASE	COMMENTS
L4 -01				●						
L4 -02	●									
L4 -03	●									
L4 -04				●						
L4 -05	●									
L4 -06	●									
L4 -07				●						
L4 -08				●						
L4 -09	●									
L4 -10				●						
L4 -11				●						
L4 -12	●									
L4 -13			●							SMOKEGUARD
L4 -14	●									
L4 -15	●									
L4 -16					●					DOOR HOLDERS
L4 -17	●									
L4 -18								●		
L4 -19							●			
L4 -20						●				
L4 -21					●					DOOR HOLDERS
L4 -22	●									
L4 -23	●									
L4 -24	●									
L4 -25	●									
L4 -26	●									
L4 -27	●									
L4 -28	●									
L4 -29		●								ABOVE CLOUD CEILING
L4 -30		●								ABOVE CLOUD CEILING
L4 -31		●								ABOVE CLOUD CEILING
L4 -32		●								ABOVE CLOUD CEILING
L4 -33	●									
L4 -34		●								ABOVE CLOUD CEILING
L4 -35	●									
L4 -36					●					AHU-3 CONTROL
L4 -37					●					AHU-3 CONTROL
L4 -38								●		HAZ MAT SPILL ALARM
L4 -39								●		HAZ MAT SPILL ALARM
L4 -40										
L4 -41										
L4 -42										
L4 -43										
L4 -44										
L4 -45										
L4 -46										
L4 -47										
L4 -48										
L4 -49										
L4 -50										
L4 -51										
L4 -52										
L4 -53										
L4 -54										
L4 -55										
L4 -56										
L4 -57										
L4 -58										
L4 -59										
L4 -60										
TOTAL	18	5	1	6	4	1	1	3	0	

LOOP 5 – 3RD FLOOR EAST

ADDRESS	SMOKE DETECTOR WITH STANDARD BASE	SMOKE DETECTOR WITH REMOTE ALARM BASE	SMOKE DETECTOR WITH RELAY BASE	SMOKE DETECTOR MOUNTED ON HORIZONTAL SIDEWALL	TRI-R	TRI-D WATERFLOW SWITCH	TRI-D VALVE SUPERVISION	MANUAL FIRE CALL BOX	HEAT DETECTOR WITH STND BASE	COMMENTS
L5 -01	●									
L5 -02					●					FSD EAST SIDE
L5 -03					●					FSD WEST SIDE
L5 -04	●									
L5 -05	●									
L5 -06			●							SMOKEGUARD
L5 -07								●		
L5 -08					●					DOOR HOLDERS
L5 -09	●									
L5 -10						●				
L5 -11							●			
L5 -12	●									
L5 -13	●									
L5 -14	●									
L5 -15	●									
L5 -16	●									
L5 -17	●									
L5 -18	●									
L5 -19	●									
L5 -20	●									
L5 -21	●									
L5 -22	●									
L5 -23	●									
L5 -24	●									
L5 -25	●									
L5 -26	●									
L5 -27	●									
L5 -28	●									
L5 -29	●									
L5 -30	●									
L5 -31	●									
L5 -32	●									
L5 -33	●									
L5 -34	●									
L5 -35	●									
L5 -36	●									
L5 -37	●									
L5 -38	●									
L5 -39	●									
L5 -40	●									
L5 -41		●								ABOVE CLOUD CEILING
L5 -42	●									
L5 -43		●								ABOVE CLOUD CEILING
L5 -44	●									
L5 -45		●								ABOVE CLOUD CEILING
L5 -46		●								ABOVE CLOUD CEILING
L5 -47	●									
L5 -48		●								ABOVE CLOUD CEILING
L5 -49										
L5 -50										
L5 -51										
L5 -52										
L5 -53										
L5 -54										
L5 -55										
L5 -56										
L5 -57										
L5 -58										
L5 -59										
L5 -60										
TOTAL	37	5	1	0	3	1	1	1	0	

LOOP 6 – 3RD FLOOR WEST

ADDRESS	SMOKE DETECTOR WITH STANDARD BASE	SMOKE DETECTOR WITH REMOTE ALARM BASE	SMOKE DETECTOR WITH RELAY BASE	SMOKE DETECTOR MOUNTED ON HORIZONTAL SIDEWALL	TRI-R	TRI-D WATERFLOW SWITCH	TRI-D VALVE SUPERVISION	MANUAL FIRE CALL BOX	HEAT DETECTOR WITH STND BASE	COMMENTS
L6 -01	●									
L6 -02	●									
L6 -03	●									
L6 -04	●									
L6 -05	●									
L6 -06					●					DOOR HOLDERS
L6 -07	●									
L6 -08	●									
L6 -09	●									
L6 -10			●							SMOKEGUARD
L6 -11					●					DOOR HOLDERS
L6 -12	●									
L6 -13								●		
L6 -14							●			
L6 -15						●				
L6 -16	●									
L6 -17	●									
L6 -18	●									
L6 -19	●									
L6 -20	●									
L6 -21								●		
L6 -22		●								ABOVE CLOUD CEILING
L6 -23	●									
L6 -24		●								ABOVE CLOUD CEILING
L6 -25		●								ABOVE CLOUD CEILING
L6 -26	●									
L6 -27		●								ABOVE CLOUD CEILING
L6 -28	●									
L6 -29	●									
L6 -30	●									
L6 -31	●									
L6 -32	●									
L6 -33	●									
L6 -34	●									
L6 -35								●		
L6 -36	●									
L6 -37	●									
L6 -38										NOT USED
L6 -39	●									
L6 -40		●								ABOVE CLOUD CEILING
L6 -41		●								ABOVE CLOUD CEILING
L6 -42										
L6 -43										
L6 -44										
L6 -45										
L6 -46										
L6 -47										
L6 -48										
L6 -49										
L6 -50										
L6 -51										
L6 -52										
L6 -53										
L6 -54										
L6 -55										
L6 -56										
L6 -57										
L6 -58										
L6 -59										
L6 -60										
TOTAL	26	6	1	0	2	1	1	3	0	

LOOP 7 – 4TH FLOOR EAST

ADDRESS	SMOKE DETECTOR WITH STANDARD BASE	SMOKE DETECTOR WITH REMOTE ALARM BASE	SMOKE DETECTOR WITH RELAY BASE	SMOKE DETECTOR MOUNTED ON HORIZONTAL SIDEWALL	TRI-R	TRI-D WATERFLOW SWITCH	TRI-D VALVE SUPERVISION	MANUAL FIRE CALL BOX	HEAT DETECTOR WITH STND BASE	COMMENTS
L7 -01	●									
L7 -02					●					FSD EAST SIDE
L7 -03					●					FSD WEST SIDE
L7 -04	●									
L7 -05							●			AT BACKFLOW ASSY
L7 -06							●			AT BACKFLOW ASSY
L7 -07						●				AT BACKFLOW ASSY
L7 -08	●									
L7 -09			●							SMOKEGUARD
L7 -10					●					DOOR HOLDERS
L7 -11	●									
L7 -12						●				
L7 -13							●			
L7 -14								●		
L7 -15	●									
L7 -16	●									
L7 -17				●						
L7 -18	●									
L7 -19	●									
L7 -20				●						
L7 -21				●						
L7 -22	●									
L7 -23	●									
L7 -24				●						
L7 -25	●									
L7 -26				●						
L7 -27	●									
L7 -28	●									
L7 -29				●						
L7 -30	●									
L7 -31	●									
L7 -32				●						
L7 -33				●						
L7 -34	●									
L7 -35				●						
L7 -36	●									
L7 -37	●									
L7 -38					●					DOOR HOLDERS
L7 -39				●						
L7 -40	●									
L7 -41	●									
L7 -42				●						
L7 -43				●						
L7 -44	●									
L7 -45				●						
L7 -46	●									
L7 -47	●									
L7 -48				●						
L7 -49				●						
L7 -50	●									
L7 -51	●									
L7 -52	●									
L7 -53					●					OXYGEN SENSOR
L7 -54										
L7 -55										
L7 -56										
L7 -57										
L7 -58										
L7 -59										
L7 -60										
TOTAL	26	0	1	15	4	2	3	1	0	

LOOP 8 – 4TH FLOOR WEST

ADDRESS	SMOKE DETECTOR WITH STANDARD BASE	SMOKE DETECTOR WITH REMOTE ALARM BASE	SMOKE DETECTOR WITH RELAY BASE	SMOKE DETECTOR MOUNTED ON HORIZONTAL SIDEWALL	TRI-R	TRI-D WATERFLOW SWITCH	TRI-D VALVE SUPERVISION	MANUAL FIRE CALL BOX	HEAT DETECTOR WITH STND BASE	COMMENTS
L8 -01			●							SMOKEGUARD
L8 -02	●									
L8 -03	●									
L8 -04	●									
L8 -05					●					DOOR HOLDERS
L8 -06	●									
L8 -07								●		
L8 -08							●			
L8 -09						●				
L8 -10	●									
L8 -11	●									
L8 -12					●					ROLL DOWN DOOR
L8 -13	●									
L8 -14	●									
L8 -15	●									
L8 -16	●									
L8 -17					●					DOOR HOLDERS
L8 -18	●									
L8 -19	●									
L8 -20	●									
L8 -21	●									
L8 -22	●									
L8 -23	●									
L8 -24	●									
L8 -25	●									
L8 -26	●									
L8 -27	●									
L8 -28	●									
L8 -29	●									
L8 -30	●									
L8 -31	●									
L8 -32	●									
L8 -33	●									
L8 -34	●									
L8 -35	●									
L8 -36	●									
L8 -37	●									
L8 -38	●									
L8 -39	●									
L8 -40	●									
L8 -41	●									
L8 -42	●									
L8 -43	●									
L8 -44	●									
L8 -45	●									
L8 -46	●									
L8 -47	●									
L8 -48										
L8 -49										
L8 -50										
L8 -51										
L8 -52										
L8 -53										
L8 -54										
L8 -55										
L8 -56										
L8 -57										
L8 -58										
L8 -59										
L8 -60										
TOTAL	40	0	1	0	3	1	1	1	0	

LOOP 9 – 5TH FLOOR EAST

ADDRESS	SMOKE DETECTOR WITH STANDARD BASE	SMOKE DETECTOR WITH REMOTE ALARM BASE	SMOKE DETECTOR WITH RELAY BASE	SMOKE DETECTOR MOUNTED ON HORIZONTAL SIDEWALL	TRI-R	TRI-D WATERFLOW SWITCH	TRI-D VALVE SUPERVISION	MANUAL FIRE CALL BOX	HEAT DETECTOR WITH STND BASE	COMMENTS
L9 -01							●			
L9 -02						●				
L9 -03	●									
L9 -04					●					WON DOOR
L9 -05	●									
L9 -06			●							SMOKEGUARD
L9 -07								●		
L9 -08	●									
L9 -09	●									
L9 -10	●									
L9 -11					●					FSD EAST SIDE
L9 -12					●					FSD WEST SIDE
L9 -13	●									
L9 -14				●						
L9 -15	●									
L9 -16	●									
L9 -17				●						
L9 -18	●									
L9 -19	●									
L9 -20				●						
L9 -21	●									
L9 -22	●									
L9 -23				●						
L9 -24	●									
L9 -25				●						
L9 -26	●									
L9 -27				●						
L9 -28	●									
L9 -29	●									
L9 -30				●						
L9 -31	●									
L9 -32				●						
L9 -33	●									
L9 -34	●									
L9 -35	●									
L9 -36	●									
L9 -37				●						
L9 -38					●					DOOR HOLDERS
L9 -39	●									
L9 -40	●									
L9 -41				●						
L9 -42	●									
L9 -43				●						
L9 -44				●						
L9 -45	●									
L9 -46				●						
L9 -47	●									
L9 -48	●									
L9 -49				●						
L9 -50	●									
L9 -51				●						
L9 -52										
L9 -53										
L9 -54										
L9 -55										
L9 -56										
L9 -57										
L9 -58										
L9 -59										
L9 -60										
TOTAL	28	0	1	15	4	1	1	1	0	

LOOP 10 – 5TH FLOOR WEST

ADDRESS	SMOKE DETECTOR WITH STANDARD BASE	SMOKE DETECTOR WITH REMOTE ALARM BASE	SMOKE DETECTOR WITH RELAY BASE	SMOKE DETECTOR MOUNTED ON HORIZONTAL SIDEWALL	TRI-R	TRI-D WATERFLOW SWITCH	TRI-D VALVE SUPERVISION	MANUAL FIRE CALL BOX	HEAT DETECTOR WITH STND BASE	COMMENTS
L10 -01			●							SMOKEGUARD
L10 -02	●									
L10 -03	●									
L10 -04	●									
L10 -05					●					DOOR HOLDERS
L10 -06	●									
L10 -07								●		
L10 -08							●			
L10 -09						●				
L10 -10	●									
L10 -11	●									
L10 -12	●									
L10 -13					●					DOOR HOLDERS
L10 -14					●					DOOR HOLDERS
L10 -15	●									
L10 -16	●									
L10 -17	●									
L10 -18					●					DOOR HOLDERS
L10 -19	●									
L10 -20	●									
L10 -21	●									
L10 -22								●		
L10 -23	●									
L10 -24	●									
L10 -25	●									
L10 -26	●									
L10 -27	●									
L10 -28	●									
L10 -29	●									
L10 -30	●									
L10 -31	●									
L10 -32	●									
L10 -33	●									
L10 -34	●									
L10 -35	●									
L10 -36	●									
L10 -37	●									
L10 -38	●									
L10 -39	●									
L10 -40	●									
L10 -41	●									
L10 -42	●									
L10 -43	●									
L10 -44	●									
L10 -45	●									
L10 -46	●									
L10 -47	●									
L10 -48	●									
L10 -49										
L10 -50										
L10 -51										
L10 -52										
L10 -53										
L10 -54										
L10 -55										
L10 -56										
L10 -57										
L10 -58										
L10 -59										
L10 -60										
TOTAL	39	0	1	0	4	1	1	2	0	

LOOP 11 – 6TH FLOOR EAST

ADDRESS	SMOKE DETECTOR WITH STANDARD BASE	SMOKE DETECTOR WITH REMOTE ALARM BASE	SMOKE DETECTOR WITH RELAY BASE	SMOKE DETECTOR MOUNTED ON HORIZONTAL SIDEWALL	TRI-R	TRI-D WATERFLOW SWITCH	TRI-D VALVE SUPERVISION	MANUAL FIRE CALL BOX	HEAT DETECTOR WITH STND BASE	COMMENTS
L11 -01	●									
L11 -02					●					FSD EAST SIDE
L11 -03					●					FSD WEST SIDE
L11 -04	●									
L11 -05	●									
L11 -06			●							SMOKEGUARD
L11 -07					●					DOOR HOLDERS
L11 -08								●		
L11 -09	●									
L11 -10						●				
L11 -11							●			
L11 -12	●									
L11 -13	●									
L11 -14				●						
L11 -15	●									
L11 -16				●						
L11 -17	●									
L11 -18	●									
L11 -19				●						
L11 -20	●									
L11 -21	●									
L11 -22				●						
L11 -23	●									
L11 -24	●									
L11 -25				●						
L11 -26				●						
L11 -27	●									
L11 -28	●									
L11 -29				●						
L11 -30	●									
L11 -31				●						
L11 -32	●									
L11 -33				●						
L11 -34	●									
L11 -35					●					DOOR HOLDERS
L11 -36	●									
L11 -37				●						
L11 -38				●						
L11 -39	●									
L11 -40				●						
L11 -41				●						
L11 -42				●						
L11 -43				●						
L11 -44	●									
L11 -45	●									
L11 -46	●									
L11 -47					●					OXYGEN SENSOR
L11 -48										
L11 -49										
L11 -50										
L11 -51										
L11 -52										
L11 -53										
L11 -54										
L11 -55										
L11 -56										
L11 -57										
L11 -58										
L11 -59										
L11 -60										
TOTAL	23	0	1	15	4	1	1	1	0	

LOOP 12 – 6TH FLOOR WEST

ADDRESS	SMOKE DETECTOR WITH STANDARD BASE	SMOKE DETECTOR WITH REMOTE ALARM BASE	SMOKE DETECTOR WITH RELAY BASE	SMOKE DETECTOR MOUNTED ON HORIZONTAL SIDEWALL	TRI-R	TRI-D WATERFLOW SWITCH	TRI-D VALVE SUPERVISION	MANUAL FIRE CALL BOX	HEAT DETECTOR WITH STND BASE	COMMENTS
L12 -01			●							SMOKEGUARD
L12 -02	●									
L12 -03	●									
L12 -04	●									
L12 -05					●					DOOR HOLDERS
L12 -06	●									
L12 -07								●		
L12 -08							●			
L12 -09						●				
L12 -10	●									
L12 -11	●									
L12 -12	●									
L12 -13					●					DOOR HOLDERS
L12 -14					●					ROLL DOWN DOOR
L12 -15	●									
L12 -16	●									
L12 -17	●									
L12 -18	●									
L12 -19					●					DOOR HOLDERS
L12 -20	●									
L12 -21	●									
L12 -22	●									
L12 -23								●		
L12 -24	●									
L12 -25	●									
L12 -26	●									
L12 -27	●									
L12 -28	●									
L12 -29	●									
L12 -30	●									
L12 -31	●									
L12 -32	●									
L12 -33	●									
L12 -34	●									
L12 -35	●									
L12 -36	●									
L12 -37	●									
L12 -38	●									
L12 -39	●									
L12 -40	●									
L12 -41	●									
L12 -42	●									
L12 -43	●									
L12 -44	●									
L12 -45	●									
L12 -46	●									
L12 -47										
L12 -48										
L12 -49										
L12 -50										
L12 -51										
L12 -52										
L12 -53										
L12 -54										
L12 -55										
L12 -56										
L12 -57										
L12 -58										
L12 -59										
L12 -60										
TOTAL	37	0	1	0	4	1	1	2	0	

LOOP 13 – ROOF

ADDRESS	SMOKE DETECTOR WITH STANDARD BASE	SMOKE DETECTOR WITH REMOTE ALARM BASE	SMOKE DETECTOR WITH RELAY BASE	SMOKE DETECTOR MOUNTED ON HORIZONTAL SIDEWALL	TRI-R	TRI-D WATERFLOW SWITCH	TRI-D VALVE SUPERVISION	MANUAL FIRE CALL BOX	HEAT DETECTOR WITH STND BASE	COMMENTS
L13 -01	●									
L13 -02					●					ELEV PWR SHUNT
L13 -03							●			
L13 -04						●				
L13 -05					●					FAN STATUS
L13 -06					●					FAN SHUTDOWN
L13 -07					●					BL-006
L13 -08										NOT USED
L13 -09	●									
L13 -10									●	
L13 -11					●					PRIMARY ELEV RECALL
L13 -12					●					SECONDARY RECALL
L13 -13	●									
L13 -14								●		
L13 -15	●									
L13 -16							●			
L13 -17						●				
L13 -18							●			
L13 -19						●				
L13 -20					●					PRIMARY ELEV RECALL
L13 -21					●					SECONDARY RECALL
L13 -22	●									
L13 -23									●	
L13 -24					●					ELEV PWR SHUNT
L13 -25			●							SMOKEGUARD
L13 -26					●					FAN STATUS
L13 -27					●					FAN SHUTDOWN
L13 -28					●					BL-001
L13 -29				●						ELEVATOR SHAFT
L13 -30				●						ELEVATOR SHAFT
L13 -31					●					FF OVERRIDE BYPASS
L13 -32					●					FF OVERRIDE BYPASS
L13 -33										
L13 -34										
L13 -35										
L13 -36										
L13 -37										
L13 -38										
L13 -39										
L13 -40										
L13 -41										
L13 -42										
L13 -43										
L13 -44										
L13 -45										
L13 -46										
L13 -47										
L13 -48										
L13 -49										
L13 -50										
L13 -51										
L13 -52										
L13 -53										
L13 -54										
L13 -55										
L13 -56										
L13 -57										
L13 -58										
L13 -59										
L13 -60										
TOTAL	5	0	1	2	14	3	3	1	2	

LOOP 14 – UTILITY BUILDING

ADDRESS	SMOKE DETECTOR WITH STANDARD BASE	SMOKE DETECTOR WITH REMOTE ALARM BASE	SMOKE DETECTOR WITH RELAY BASE	SMOKE DETECTOR MOUNTED ON HORIZONTAL SIDEWALL	TRI-R	TRI-D WATERFLOW SWITCH	TRI-D VALVE SUPERVISION	MANUAL FIRE CALL BOX	HEAT DETECTOR WITH STND BASE	COMMENTS
L14 -01	●									
L14 -02	●									
L14 -03	●									
L14 -04	●									
L14 -05	●									
L14 -06	●									
L14 -07	●									
L14 -08								●		
L14 -09								●		
L14 -10								●		
L14 -11	●									
L14 -12	●									
L14 -13	●									
L14 -14	●									
L14 -15								●		
L14 -16	●									
L14 -17	●									
L14 -18	●									
L14 -19	●									
L14 -20							●			
L14 -21						●				
L14 -22					●					FAN SHUTDOWN
L14 -23					●					FAN SHUTDOWN
L14 -24					●					FAN SHUTDOWN
L14 -25					●					FAN SHUTDOWN
L14 -26					●					FAP-004-67
L14 -27					●					FAP-005-67
L14 -28					●					FAP-006-67
L14 -29						●				PAD-3 FAP-007-67
L14 -30						●				PAD-3 FAP-007-67
L14 -31										
L14 -32										
L14 -33										
L14 -34										
L14 -35										
L14 -36										
L14 -37										
L14 -38										
L14 -39										
L14 -40										
L14 -41										
L14 -42										
L14 -43										
L14 -44										
L14 -45										
L14 -46										
L14 -47										
L14 -48										
L14 -49										
L14 -50										
L14 -51										
L14 -52										
L14 -53										
L14 -54										
L14 -55										
L14 -56										
L14 -57										
L14 -58										
L14 -59										
L14 -60										
TOTAL	15	0	0	0	7	1	1	4	0	

LOOP 15 – FAN/DAMPER PANEL

ADDRESS	SMOKE DETECTOR WITH STANDARD BASE	SMOKE DETECTOR WITH REMOTE ALARM BASE	SMOKE DETECTOR WITH RELAY BASE	SMOKE DETECTOR MOUNTED ON HORIZONTAL SIDEWALL	TRI-R	TRI-D WATERFLOW SWITCH	TRI-D VALVE SUPERVISION	MANUAL FIRE CALL BOX	HEAT DETECTOR WITH STND BASE	COMMENTS
L14 -01					●					AHU-1 SHUTDOWN
L14 -02					●					AHU-2 SHUTDOWN
L14 -03					●					AHU-3 SHUTDOWN
L14 -04					●					FSD 1ST FLR EAST
L14 -05					●					FSD 2ND FLR EAST
L14 -06					●					FSD 3RD FLR EAST
L14 -07					●					FSD 4TH FLR EAST
L14 -08					●					FSD 5TH FLR EAST
L14 -09					●					FSD 6TH FLR EAST
L14 -10					●					FSD 1ST FLR WEST
L14 -11					●					FSD 2ND FLR WEST
L14 -12					●					FSD 3RD FLR WEST
L14 -13					●					FSD 4TH FLR WEST
L14 -14					●					FSD 5TH FLR WEST
L14 -15					●					FSD 6TH FLR WEST
L14 -16										
L14 -17										
L14 -18										
L14 -19										
L14 -20										
L14 -21										
L14 -22										
L14 -23										
L14 -24										
L14 -25										
L14 -26										
L14 -27										
L14 -28										
L14 -29										
L14 -30										
L14 -31										
L14 -32										
L14 -33										
L14 -34										
L14 -35										
L14 -36										
L14 -37										
L14 -38										
L14 -39										
L14 -40										
L14 -41										
L14 -42										
L14 -43										
L14 -44										
L14 -45										
L14 -46										
L14 -47										
L14 -48										
L14 -49										
L14 -50										
L14 -51										
L14 -52										
L14 -53										
L14 -54										
L14 -55										
L14 -56										
L14 -57										
L14 -58										
L14 -59										
L14 -60										
TOTAL	0	0	0	0	15	0	0	0	0	

Plot Sheet Filename: JOBS\JOBNUMBER\FILENAME
XREF Filename List: JOBS\JOBNUMBER\FILENAME
Named Page Setup: PAGE SETUP
Plot Layout: PSPACE: SHEET @ 1:1
Plot Date:

LBNL Drawing Status:
LBNL Issue Status:
LBNL Revision:
LBNL Date:

Lawrence Berkeley National Laboratory

Molecular Foundry
Building 67

Issued for	Rev	Date
RECORD DRAWINGS		18 JAN 2007

Seals and Signatures

RECORD DRAWINGS

SPECIAL NOTE:
THE INFORMATION SHOWN IN THIS DRAWING WAS DEVELOPED USING THE RECORD DRAWINGS PROVIDED BY SIEMENS BUILDING TECHNOLOGIES, INC. FOLLOWING THE COMPLETION OF THIS PROJECT (IDENTIFIED AS JOB NUMBER 107739, SHEETS 1 THROUGH 24). SPECIFICALLY, SEE SHEET 14 OF 24 FOR INFORMATION.

LBNL Project Title: MOLECULAR FOUNDRY
LBNL Building Number: 67

Key Plan

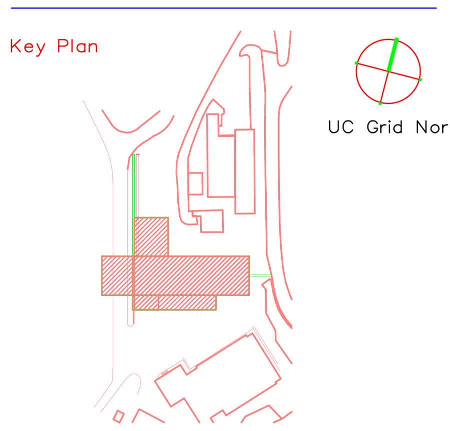

Drawing Title: FIRE ALARM SYSTEM DETAILS

Scale

MF1212

SG Project Number
LBNL Project Number

FA0.7

Drawing Number: 7 OF 20

5N67E027

LBNL Drawing Number: IFB 841