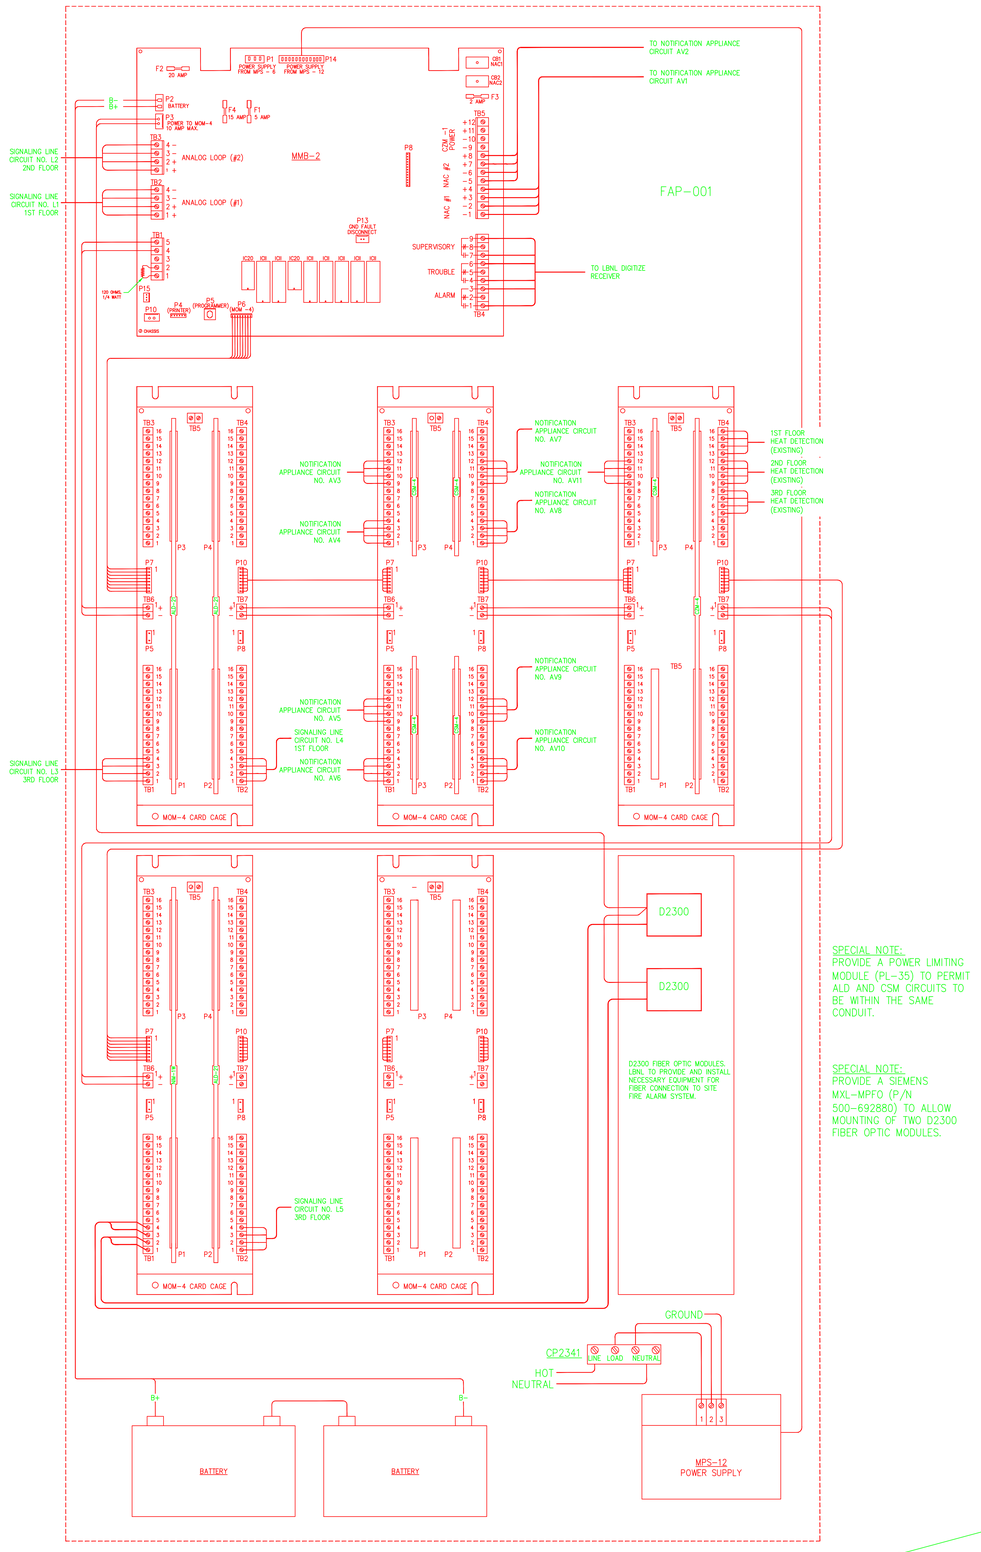


SPECIAL NOTE:
PROVIDE A POWER LIMITING MODULE (PL-35) TO PERMIT ALD AND CSM CIRCUITS TO BE WITHIN THE SAME CONDUIT.

SPECIAL NOTE:
PROVIDE A SIEMENS MXL-MPFO (P/N 500-692880) TO ALLOW MOUNTING OF TWO D2300 FIBER OPTIC MODULES.

1 FIRE ALARM CONTROL UNIT DETAIL
FA0.1.2 SCALE: NONE

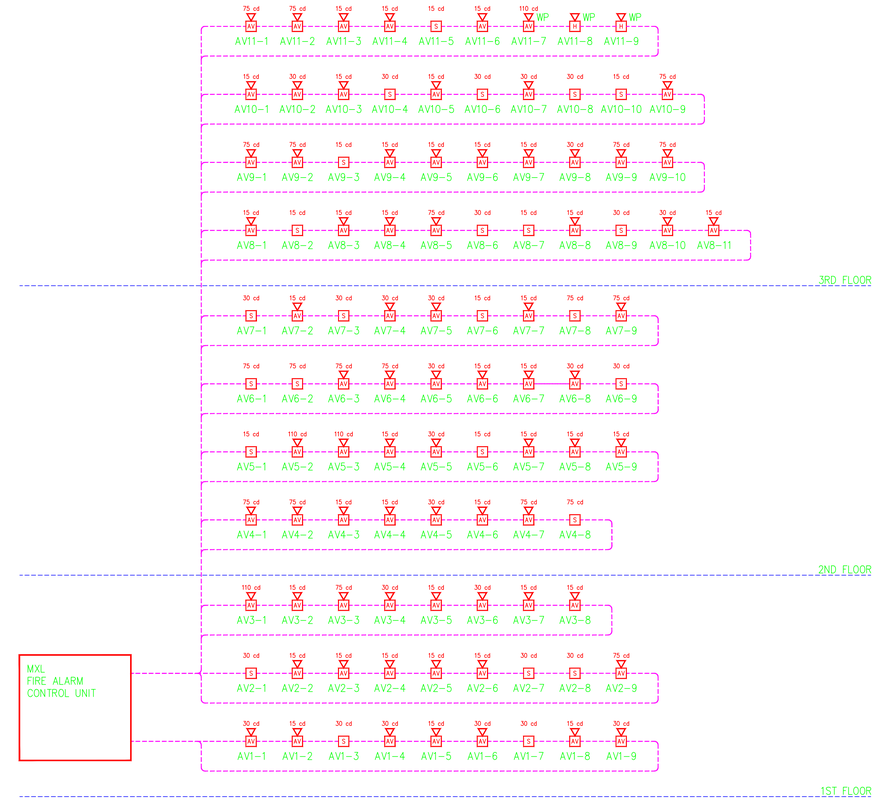


2 NOTIFICATION APPLIANCE RISER DIAGRAM
FA0.1.2 SCALE: NONE

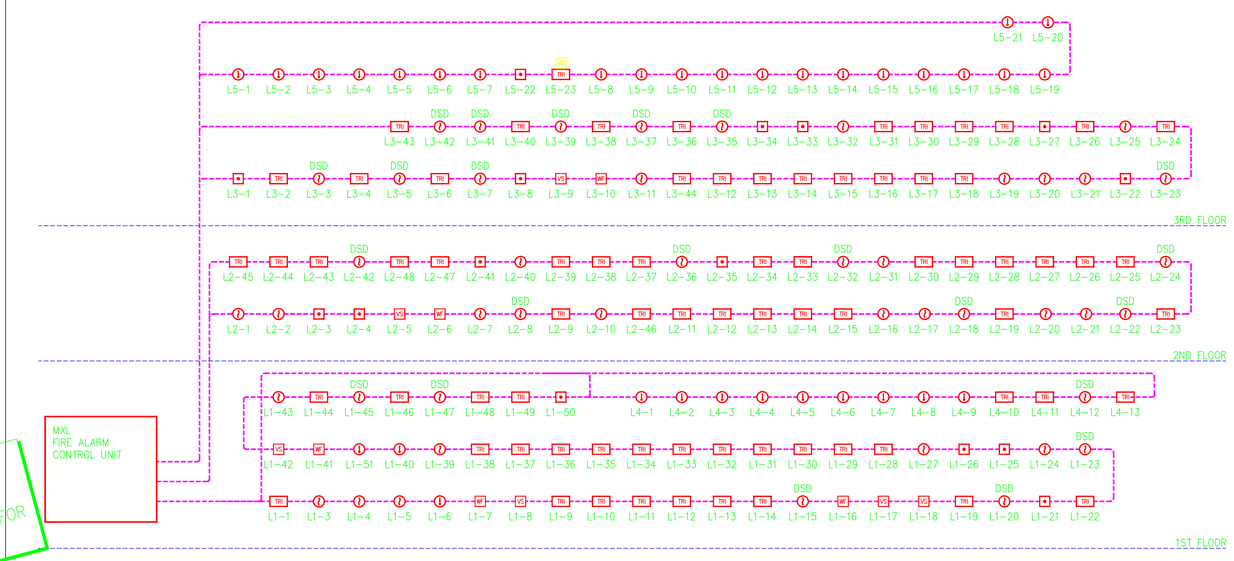


3 SIGNALING LINE CIRCUIT RISER DIAGRAM
FA0.1.2 SCALE: NONE

"AS BUILT" NOTE:
REFER TO SIEMENS INDUSTRY (INSTALLATION CONTRACTOR) "AS BUILT" PLANS AND DETAILS FOR FINAL LAYOUT OF THE FIRE ALARM SYSTEMS.

UNIVERSITY OF CALIFORNIA
LAWRENCE BERKELEY NATIONAL LABORATORY
FACILITIES DIVISION
BERKELEY LAB
OWNER

RMW architecture & interiors
vision function space culture ideas
160 Pine Street
San Francisco, CA 94111
Tel 415.781.9800
Fax 415.788.5216
www.rmw.com
CONSULTING FIRM

HYT Corporation
Fire Protection Engineers and Consultants
3498 Clayton Road - Suite 101 Concord, California 94519
Phone: (925) 681-2731 FAX: (925) 681-2733
CONSULTING A/E FIRM

REGISTERED PROFESSIONAL ENGINEER
No. 1165
Exp. 9/30/10
FIRE PROTECTION
STATE OF CALIFORNIA
PROFESSIONAL SEAL (IF REVISION, APPLIES ONLY TO REVISED WORK)

"AS BUILT"
05/2013
ISSUE (PROGRESS, ESTIMATE, BID, CONSTRUCTION, CONFORMED, REVISION, AS-BUILT)

| REVISION NUMBER | DRAWN BY | CHECKED BY | APPRVD BY | DATE | REMARKS |
|---|---|---|---|---|---|

LBNL "AS BUILT – SEISMIC PHASE 2"
BUILDING 74
RISER SCHEMATICS AND DETAILS, FIRE ALARM

UNIVERSITY OF CALIFORNIA
LAWRENCE BERKELEY NATIONAL LABORATORY
FACILITIES DIVISION

| | | |
|---|---|---|
| DRAWN BY | HYT | DATE |
| CHECKED BY | HYT | 05/2013 |
| APPROVED BY | | |
| CAD FILE PATH | | |
| SCALE | As Noted | |
| DRAWING NO | 6N74E277_ | SHEET FA0.1.2 |
| PROJECT NO | 29090.00 | |