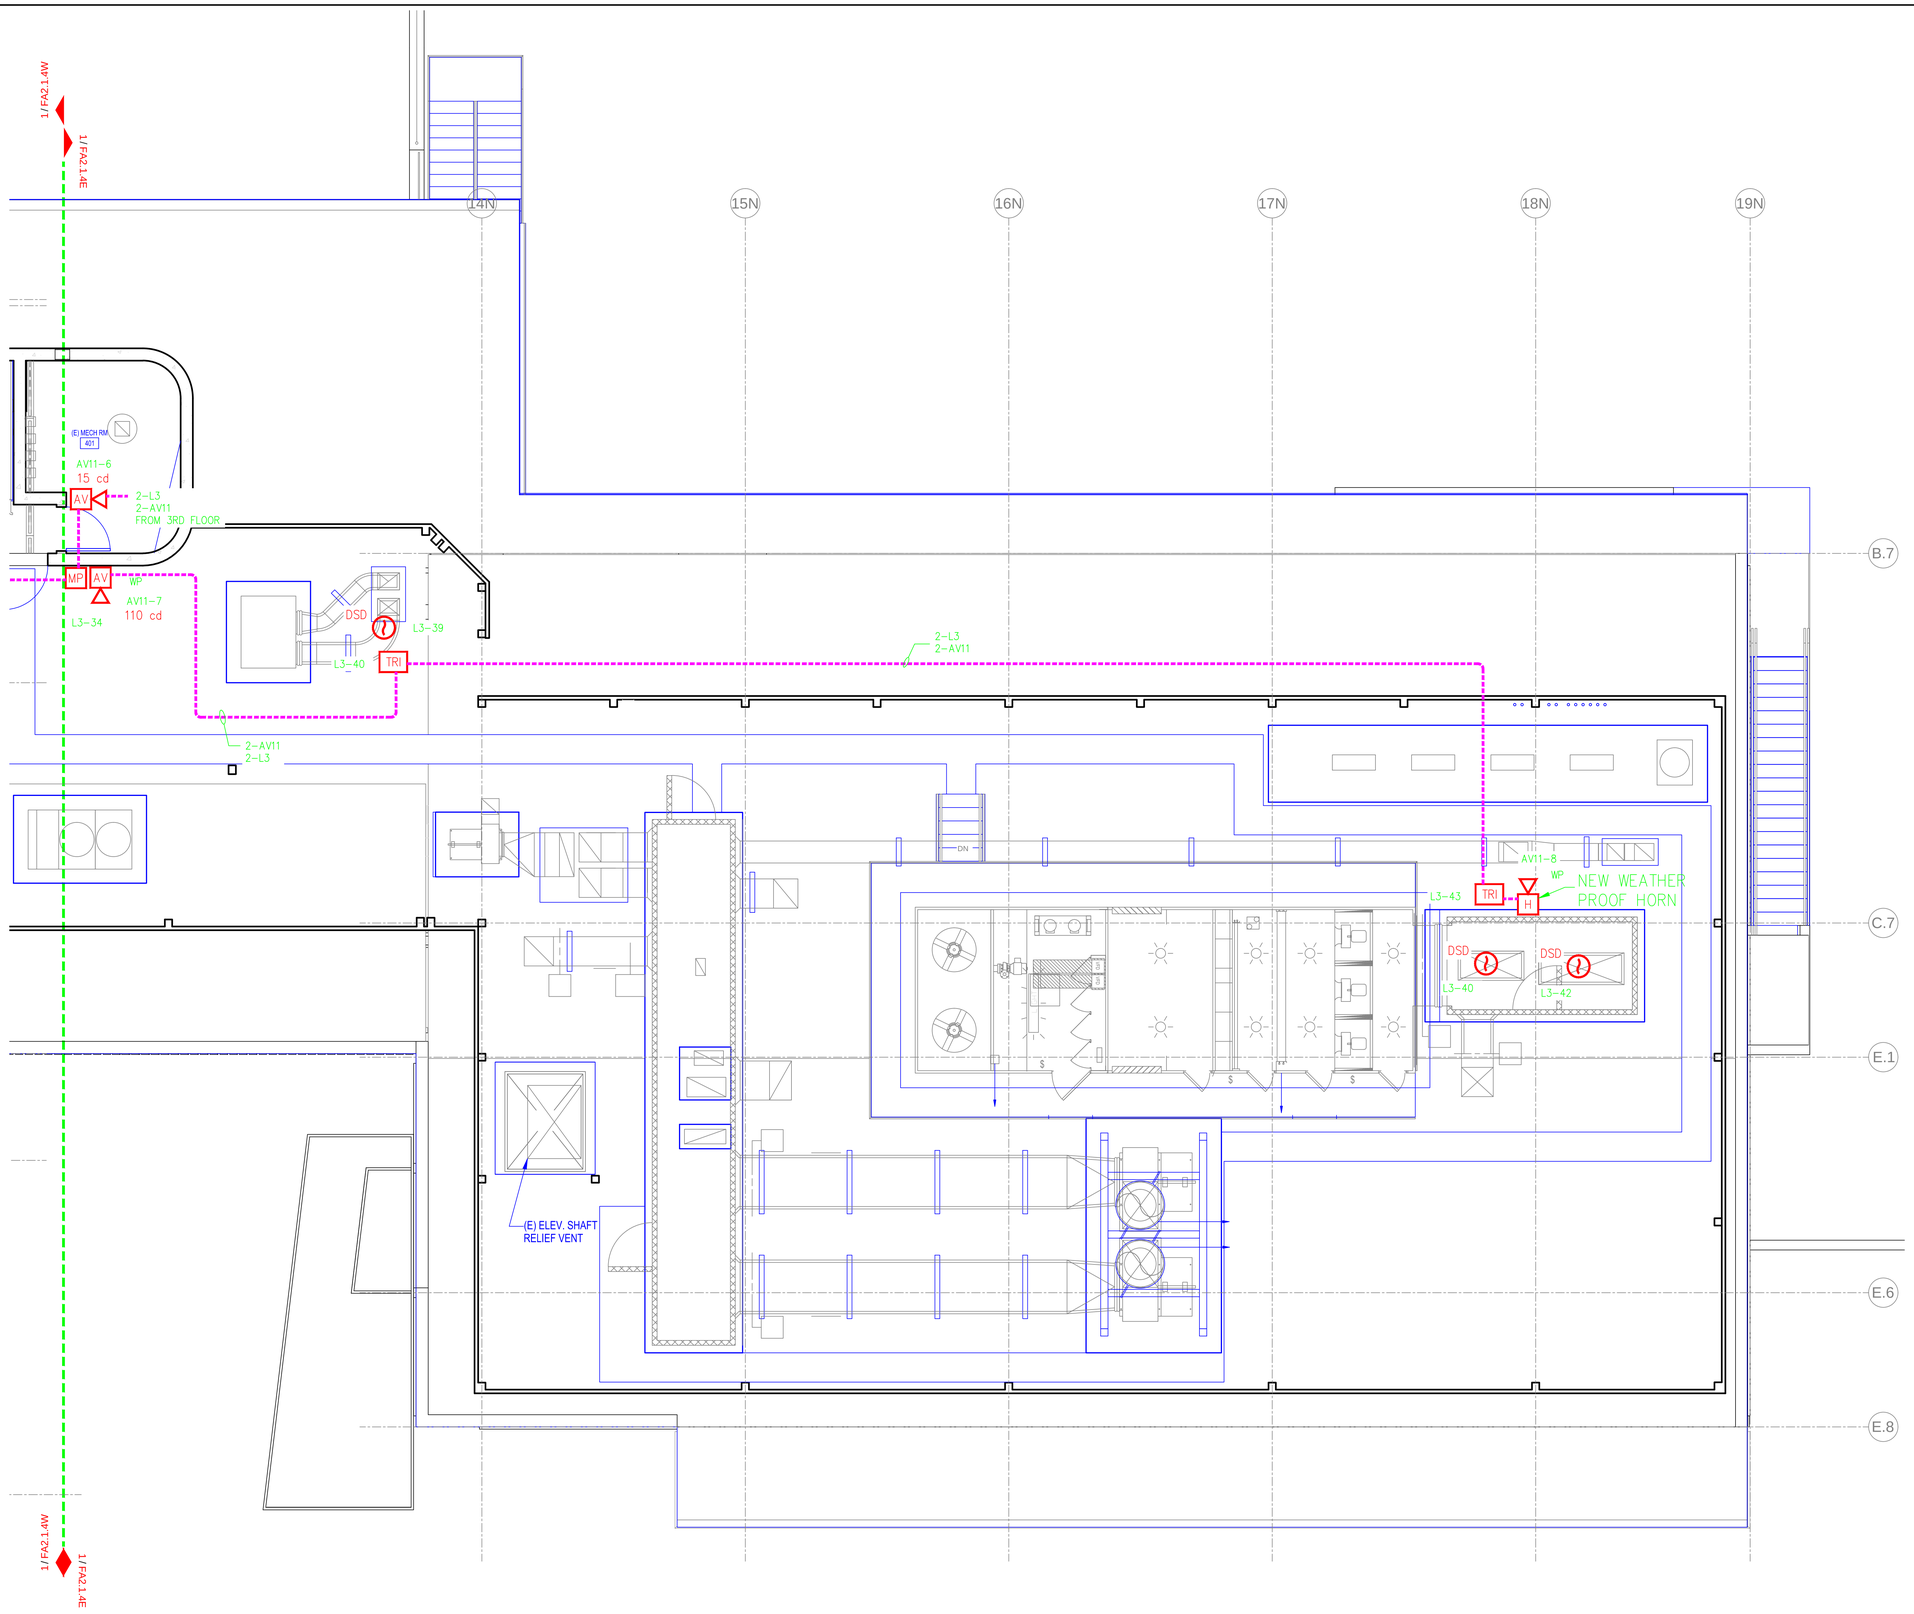

"AS BUILT" NOTE:
REFER TO SIEMENS INDUSTRY (INSTALLATION CONTRACTOR) "AS BUILT" PLANS AND DETAILS FOR FINAL LAYOUT OF THE FIRE ALARM SYSTEMS.

1 ROOF FIRE ALARM PLAN - EAST
1/4" = 1'-0"

UNIVERSITY OF CALIFORNIA
LAWRENCE BERKELEY NATIONAL LABORATORY
FACILITIES DIVISION
BERKELEY LAB

160 Pine Street
San Francisco, CA 94111

Tel 415.781.9800
Fax 415.788.5216
www.rmw.com

"AS BUILT"
05/2013

REVISION NUMBER	DRAWN BY	CHECKED BY	APPR'D BY	DATE	REMARKS

LBNL "AS BUILT -- SEISMIC PHASE 2"
BUILDING 74
ROOF, FIRE ALARM PLAN - EAST

UNIVERSITY OF CALIFORNIA
LAWRENCE BERKELEY NATIONAL LABORATORY
FACILITIES DIVISION

DRAWN BY	HYT	DATE
CHECKED BY	HYT	05/2013
APPROVED BY		
CAD FILE PATH		
SCALE	As Noted	
DRAWING NO.	6N74E287_	SHEET FA2.1.4E
PROJECT NO.	20090.00	

OWNER | CONSULTING FIRM | CONSULTING A/E FIRM | PROFESSIONAL SEAL IF REVISION, APPLIES ONLY TO REVISED WORK | ISSUE (PROGRESS, ESTIMATE, BID, CONSTRUCTION, CONFORMED, REVISION, AS-BUILT)