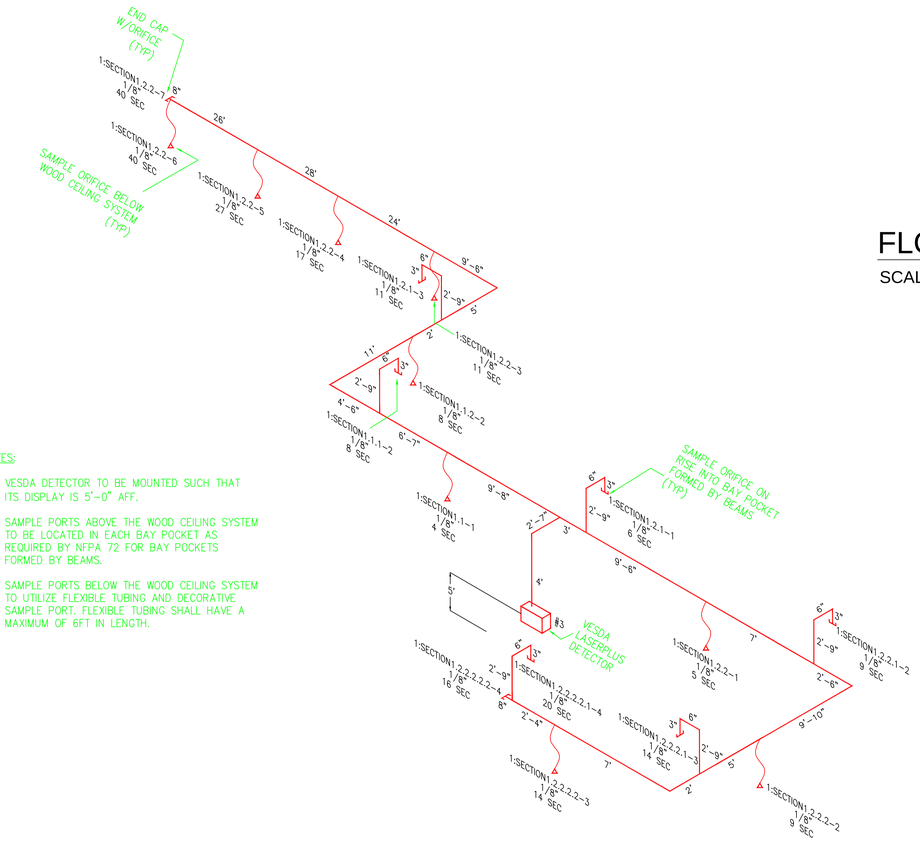

FLOOR 2 HALLWAY HSSD#3 SCHEMATIC

SCALE: None

NOTES:

1. VESDA DETECTOR TO BE MOUNTED SUCH THAT ITS DISPLAY IS 5'-0" AFF.
2. SAMPLE PORTS ABOVE THE WOOD CEILING SYSTEM TO BE LOCATED IN EACH BAY POCKET AS REQUIRED BY NFPA 72 FOR BAY POCKETS FORMED BY BEAMS.
3. SAMPLE PORTS BELOW THE WOOD CEILING SYSTEM TO UTILIZE FLEXIBLE TUBING AND DECORATIVE SAMPLE PORT. FLEXIBLE TUBING SHALL HAVE A MAXIMUM OF 6FT IN LENGTH.

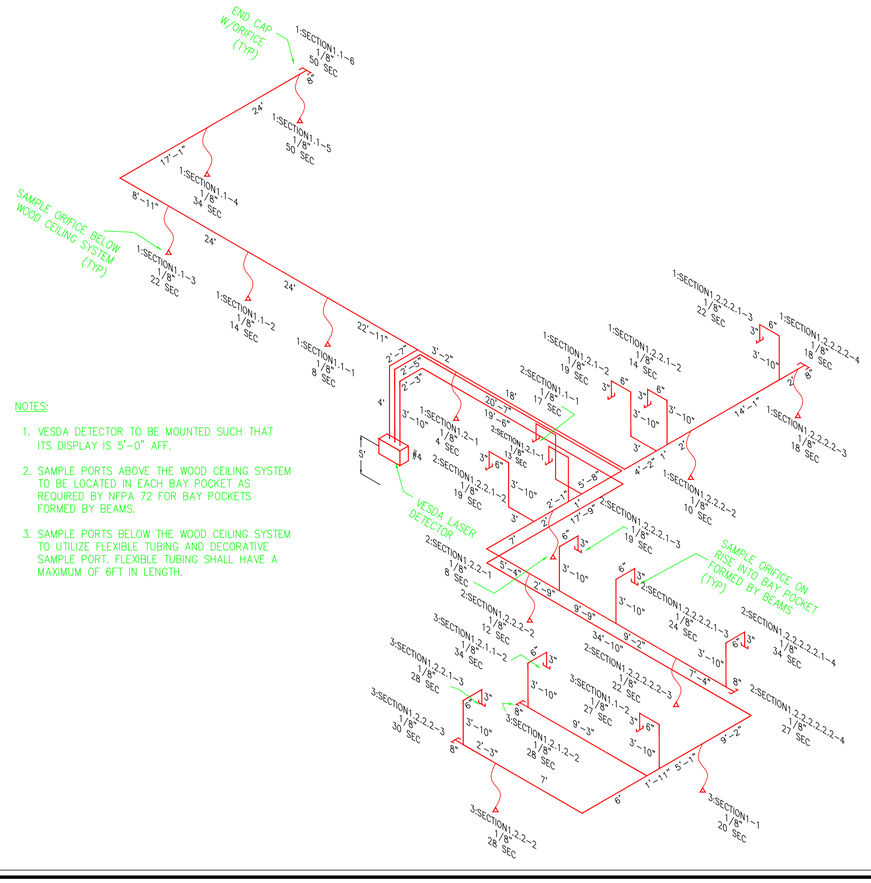

FLOOR 3 HALLWAY HSSD#4 SCHEMATIC

SCALE: None

NOTES:

1. VESDA DETECTOR TO BE MOUNTED SUCH THAT ITS DISPLAY IS 5'-0" AFF.
2. SAMPLE PORTS ABOVE THE WOOD CEILING SYSTEM TO BE LOCATED IN EACH BAY POCKET AS REQUIRED BY NFPA 72 FOR BAY POCKETS FORMED BY BEAMS.
3. SAMPLE PORTS BELOW THE WOOD CEILING SYSTEM TO UTILIZE FLEXIBLE TUBING AND DECORATIVE SAMPLE PORT. FLEXIBLE TUBING SHALL HAVE A MAXIMUM OF 6FT IN LENGTH.

THE DRAWING AND DESIGN HEREON SHALL NOT BE DUPLICATED, USED OR DISCLOSED TO OTHERS FOR PROCUREMENT OF OTHER PURPOSE EXCEPT AS OTHERWISE AUTHORIZED BY CONTRACT WITHOUT WRITTEN PERMISSION OF SIEMENS BUILDING TECHNOLOGIES, INC., FIRE SAFETY DIVISION. ALL OTHER REPRODUCTIONS SHALL BEAR THIS NOTICE.

REVISIONS

No.	Revision	By	Date	Appr.
5A	RESPONSE TO HYT BULLETIN 5 REVIEW COMMENTS	JPM	10/19/10	KW
	AS-BUILT	JPM	9/20/12	KW

AS-BUILT

-10 APPROVAL STAMP

VENDOR OF CONTRACT DOCUMENTS:

HYT Corporation
Fire Protection Engineers and Consultants
3498 Clayton Road - Suite 101 Concord, California 94519
Phone: (925) 681-2731 FAX: (925) 681-2733

INSTALLATION CONTRACTORS NAME & ADDRESS:

W. BRADLEY ELECTRIC, INC.
90 Hill Road,
Novato, CA 94945
Tel (415) 898-1400 Fax (415) 898-5991

PROJECT MANAGER FIRM

Siemens Industry, Inc.
Fire Safety Division
25821 Industrial Boulevard, Suite 300
Hayward, California 94545-2991
Tel (510) 783-6000 Fax (510) 293-2100
California State C10 License No. 758796
U.L. Certificate ID No. 324787-001

JOB NAME & LOCATION (STREET ADDRESS)

UNIVERSITY OF CALIFORNIA
LAWRENCE BERKELEY NATIONAL LABORATORY
FACILITIES DIVISION

BUILDING 74
FIRE ALARM

LBNL SEISMIC
PHASE 2

One Cyclotron Road,
Berkeley, California 94720

SHEET CONTENTS

HSSD #3 & #4
SCHEMATICS

INSTALLATION TYPE

- ☐ NEW INSTALLATION
- ☐ DESIGN/BUILD
- ☐ PER CONTRACT DOCUMENT
- ☐ EXISTING BASE JOB # N/A
- ☐ OTHERS

SYSTEM SALES REP.:	Kevin Waxman
PROJECT MANAGER:	Mark Millard
DRAWN BY:	JPM
CAD FILE NAME:	FA-20
SCALE:	1/8" = 1'-0"
DATE DRAWN:	March 15, 2010
PLOT DATE:	March 27, 2014
SHEET:	FA-20
JOB NUMBER:	44OP-069681

DRAWING NO. 6N74E345

IF DRAWING IS SMALLER THAN 30" X 42" IT IS A REDUCED COPY