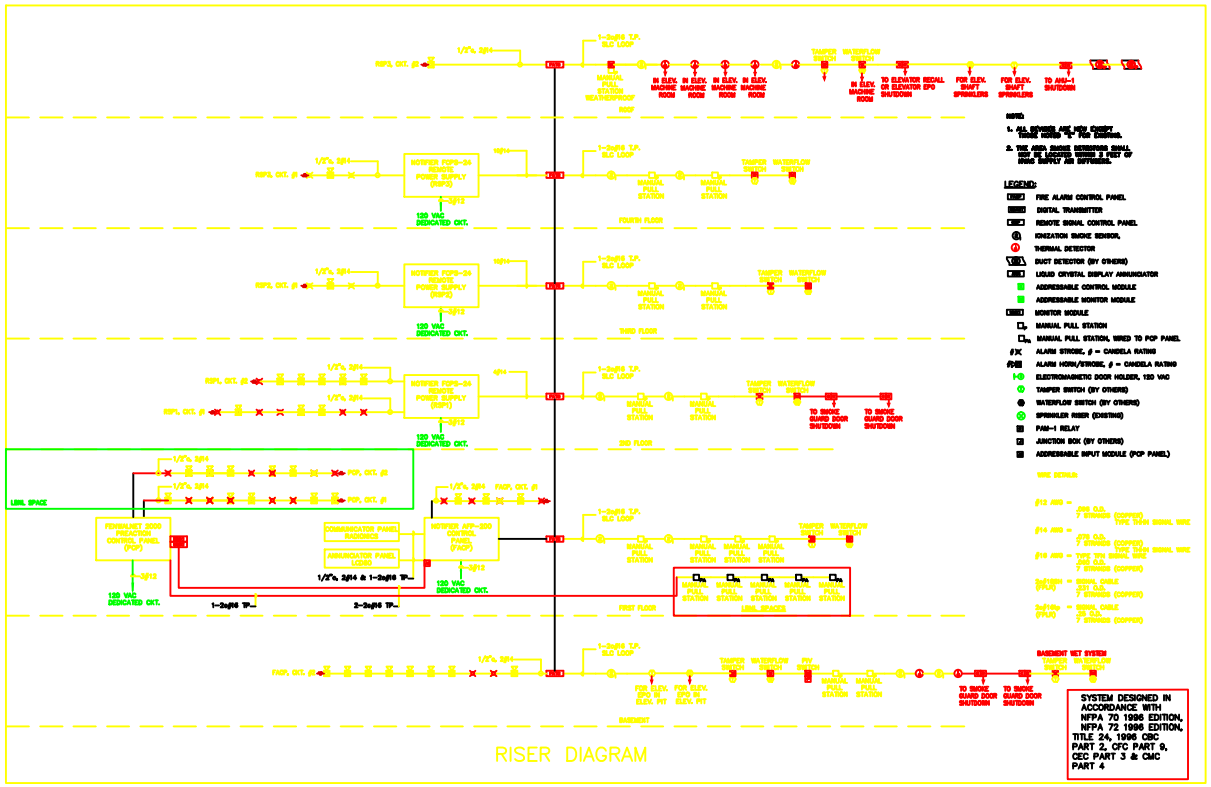

G:\Eng\AutoCAD\Support Files\GREY.lif

2600 MIRA MAR AVENUE
LONG BEACH, CA. 90815
F 562 494 3967
T 562 495 6684

TYPE OF WORK
FIRE ALARM SYSTEM

VIEW
SHED EXISTING
1400 BECHER DRIVE
SHER, CLARK, CALIFORNIA 92083-2842

NO.	DATE	DESCRIPTION	BY
1	4-24-2000	FOR REVIEW	BCA
2	4-28-2000	FOR SUBMITTAL	BCA
3	6-2-2000	BCA, PER PLAN CHECK CORRECTIONS	BCA
4	6-23-2000	CHANGE CHECK #4	BCA
5	6-23-2000	CHANGE CHECK #5	BCA
6	6-23-2000	BCA, PER PLAN CHECK CORRS. #2	BCA
7	10-10-00	AS BUILT	HB

AS BUILT BY
ELECTRICAL: NAME DATE BY
MECHANICAL: NAME DATE BY
CHECK-OUT REVIEWER: NAME DATE BY

PROJECT NAME
LAWRENCE BERKELEY NATIONAL LABORATORY COMPUTING CENTER
415 20th STREET
OAKLAND, CALIFORNIA 94612

DRAWING CONTENTS
RISER DIAGRAM

PROFESSIONAL STAMP
EXP. 01/31/2002

PROJECT NUMBER: AL-00004
FILE NAME: AL-00004RISER
DRAWN BY: BY
CHECKED BY: HB
SIGNED BY: BCA
SCALE: N/A
DRAWING NUMBER
6111
SHEET NUMBER
FP 9.0
FILE: C0012429
4N943E047
PROJ. NO. FH0113